


\\K-N\Projects\Heritage Commercial Group_HECM_Suites 202 and 221-222_Survey and As-Built_2023-0016\Drawings\595 Bethlehem Pike Suite 202, 221, 222 Survey 1-18 Survey.dwg

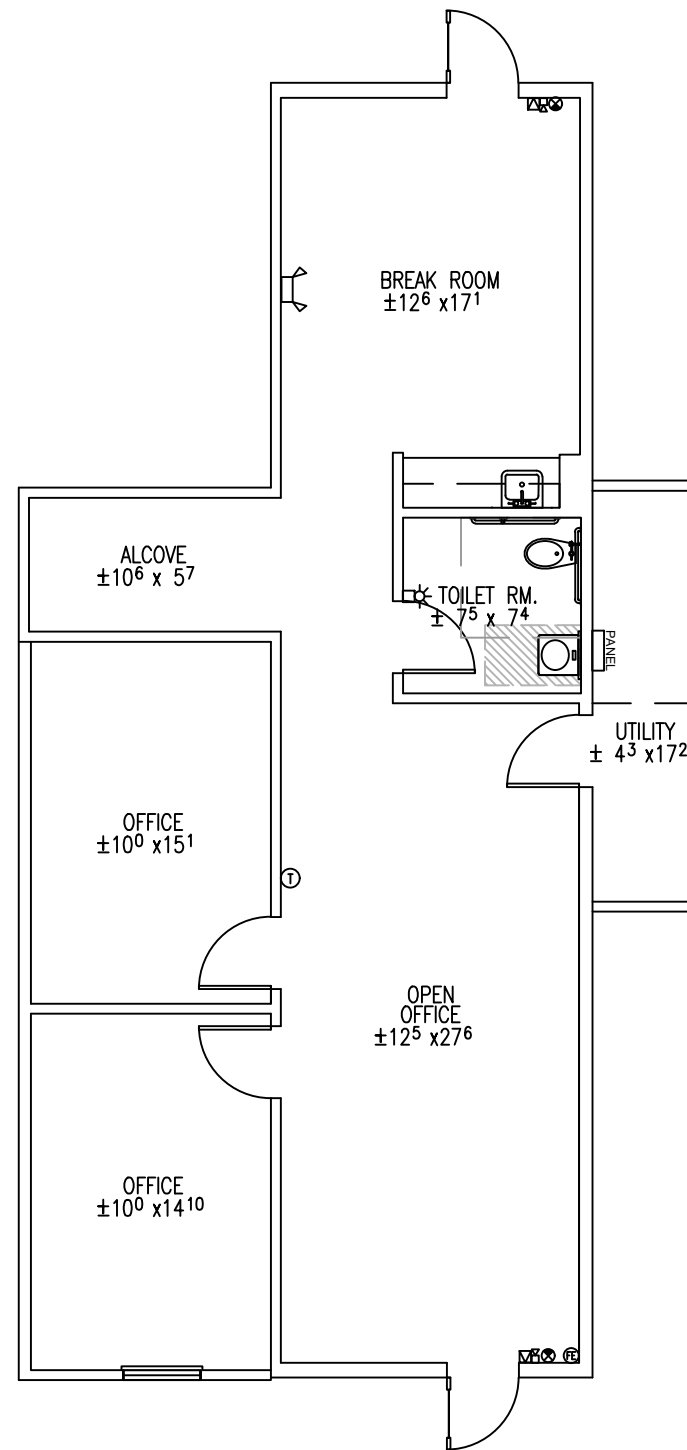

SUITE 202 - 1,124 RSF
SCALE 1/8" = 1'-0"

EXISTING CONDITIONS FOR:
SUITE 202
HERITAGE EXECUTIVE CAMPUS AT MONTGOMERYVILLE
595 BETHLEHEM PIKE
MONTGOMERYVILLE, PA 18936

RHJ ASSOCIATES, PC
ARCHITECTS · PLANNERS · DESIGNERS
PHILADELPHIA, PA 215.279.5845
KING OF PRUSSIA, PA 610.337.4555
WILMINGTON, DE 302.482.2269
www.rhjassoc.com

DATE: 02.01.2023
PROJECT NO.: 2023-0016